

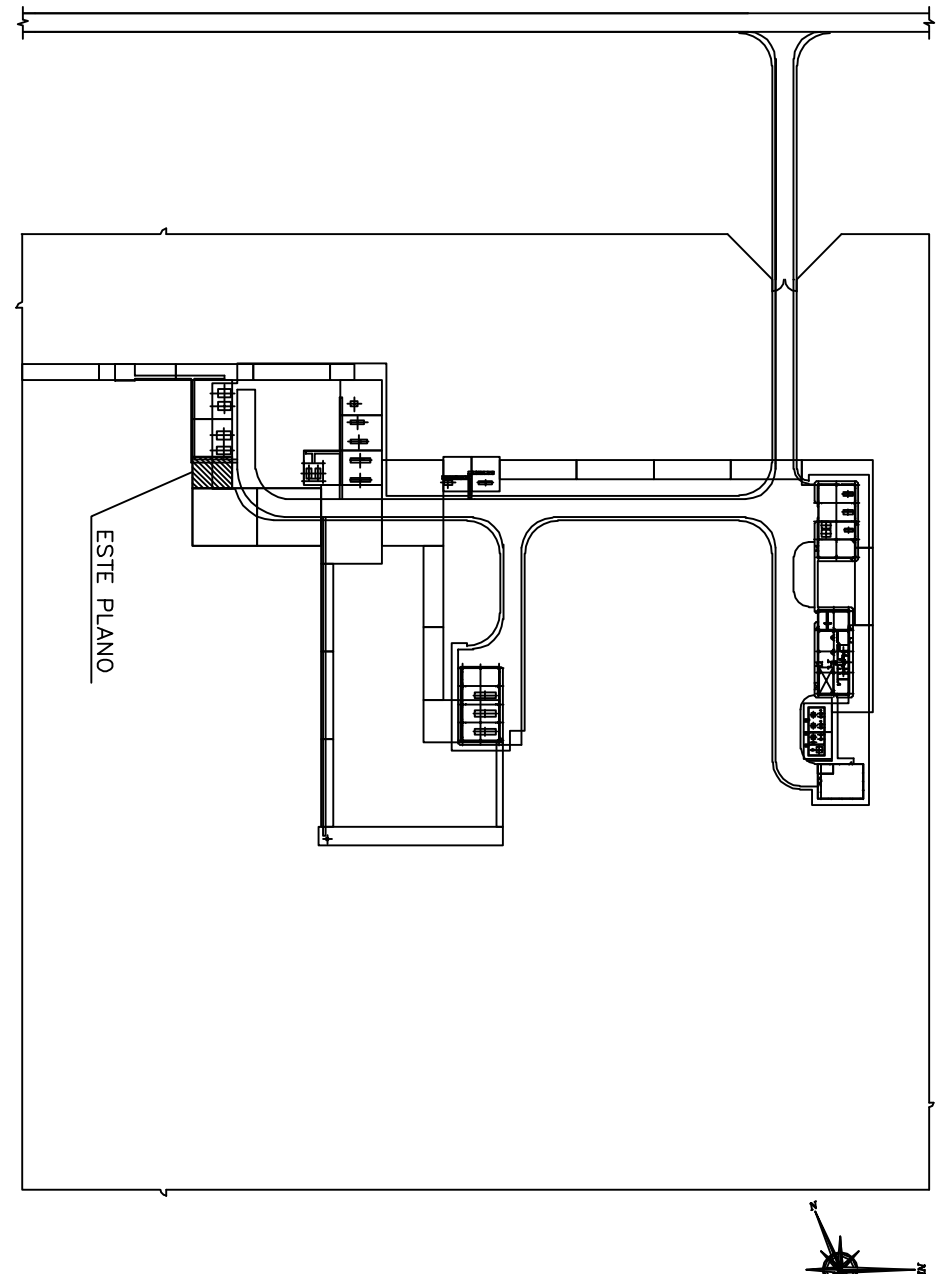


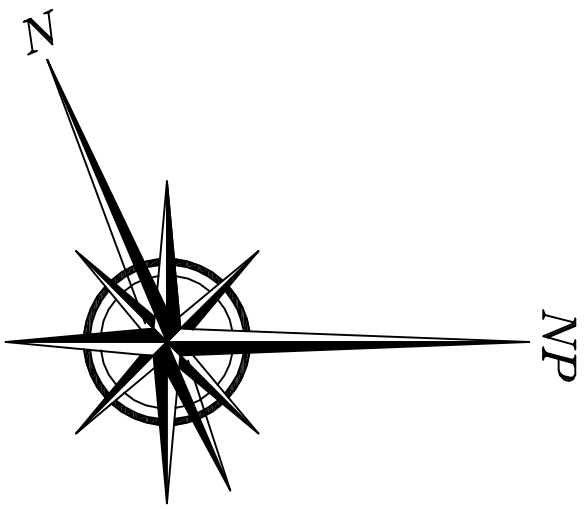

1. TODAS LAS DIMENSIONES ESTAN EN MILIMETROS SALVO INDICACION CONTRARIA.
2. LAS COORDENADAS ESTAN EXPRESADAS EN METROS EN SISTEMA GK ARGENTINA F3 POSGAR 07 DATUM ARI6.
3. TODAS LAS PROGRESIONES ESTAN REFERIDAS AL 0,00 DE PLANTA.
4. EL NIVEL 0,00 CORRESPONDE AL NIVEL 3481,531 DE LA PLANTA.
5. LOS SOPORTES DE CÁMERAS DE 1½" Y MENORES SERÁN DEFINIDOS EN OBRA POR EL CONTRATISTA.

CANERIAS ENTERRADAS

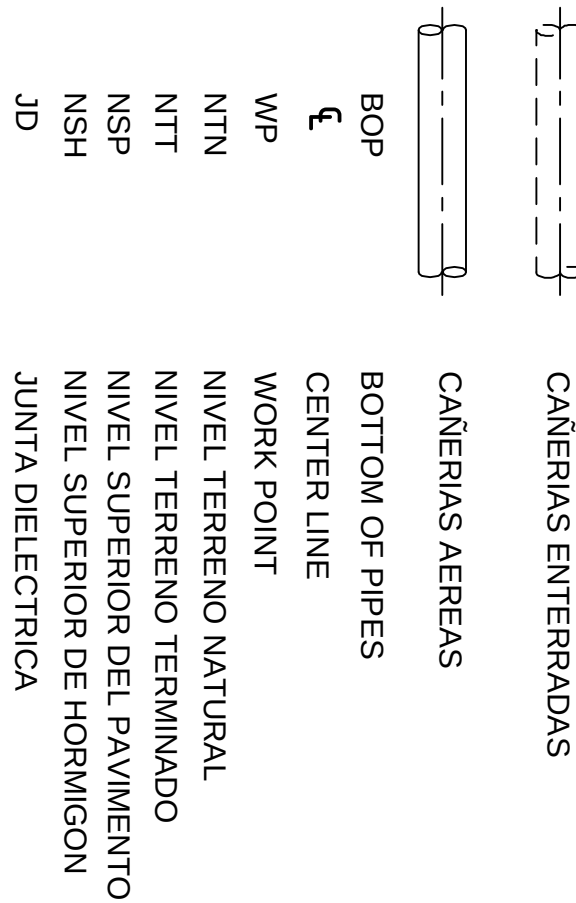

DOCUMENTOS DE REFERENCIA:

101-6410-EGEN-LY-0002 - LAY OUT - PLANTA COMPRESORA
 101-6410-EPIP-PV-0001 - KEY PLAN
 101-6410-EMEC-LY-0013 - SKID FILTROS SEPARADORES DE SALIDA
 101-6410-EPIP-DT-0001 - CADDENILLO DE SOPORTES TÍPICOS
 101-6410-EPIP-DT-0002 - PIPING HOOK UP STANDARD
 101-6410-EPIP-ET-0001 - PIPING CLASS
 101-6410-EPIP-PV-0002 - AREA LT - FILTROS SEPARADORES DE ENTRADA
 101-6410-EPIP-PV-0002-HZ - AREA G3 - FILTROS VERTICALES SEPARADORES DE SALIDA
 101-6410-ECIV-DT-0005 - PIPING SUPPORT FOUNDATIONS

	G E R E N C I A T É C N I C A	PROVINCIA DE SALTA – DPTO LA POMA PLANTA COMPRESORA RIO DE LAS BUREAS	PLANO PARA APROBACIÓN DE REMSA Y GASINOR.
		ESCALA FECHA DIBUJO REVISO 24/09/24 G3D MC	
Observaciones:			

									
CONEXTEL DOCUMENTO IDENTIFICACION PROYECTO MONITORIO		REGION DEPARTAMENTO PROVINCIA MUNICIPIO		ZONIFICACION USO TIPO		ESCRITURA VALOR VALOR		VALOR VALOR VALOR	
		Scale: 1:25				Scale: 1:25			
AREA 03 - FILTROS VERTICALES SEPARADORES DE SALIDA - HOJA 2 DE 2		RIO DE LAS BURRAS PLANTA COMPRESORA		PIPING DRAWING		PIPING DRAWING		PIPING DRAWING	
EXAMINE RESERVES THE PROPERTY OF THIS DRAWING. IT IS NOT TO BE REPRODUCED OR USED IN ANY MANNER WITHOUT THE WRITTEN AUTHORIZATION OF THE COMPANY.		EXAMINE RESERVES THE PROPERTY OF THIS DRAWING. IT IS NOT TO BE REPRODUCED OR USED IN ANY MANNER WITHOUT THE WRITTEN AUTHORIZATION OF THE COMPANY.		EXAMINE RESERVES THE PROPERTY OF THIS DRAWING. IT IS NOT TO BE REPRODUCED OR USED IN ANY MANNER WITHOUT THE WRITTEN AUTHORIZATION OF THE COMPANY.		EXAMINE RESERVES THE PROPERTY OF THIS DRAWING. IT IS NOT TO BE REPRODUCED OR USED IN ANY MANNER WITHOUT THE WRITTEN AUTHORIZATION OF THE COMPANY.		EXAMINE RESERVES THE PROPERTY OF THIS DRAWING. IT IS NOT TO BE REPRODUCED OR USED IN ANY MANNER WITHOUT THE WRITTEN AUTHORIZATION OF THE COMPANY.	
DOCUMENT NUMBER:		DATE:		L01-64-10-EP-IP-PV-0004		L01-64-10-EP-IP-PV-0004		L01-64-10-EP-IP-PV-0004	
A1		REV:		02		A1		REV:	